


Midtown MARTA Station – South Façade

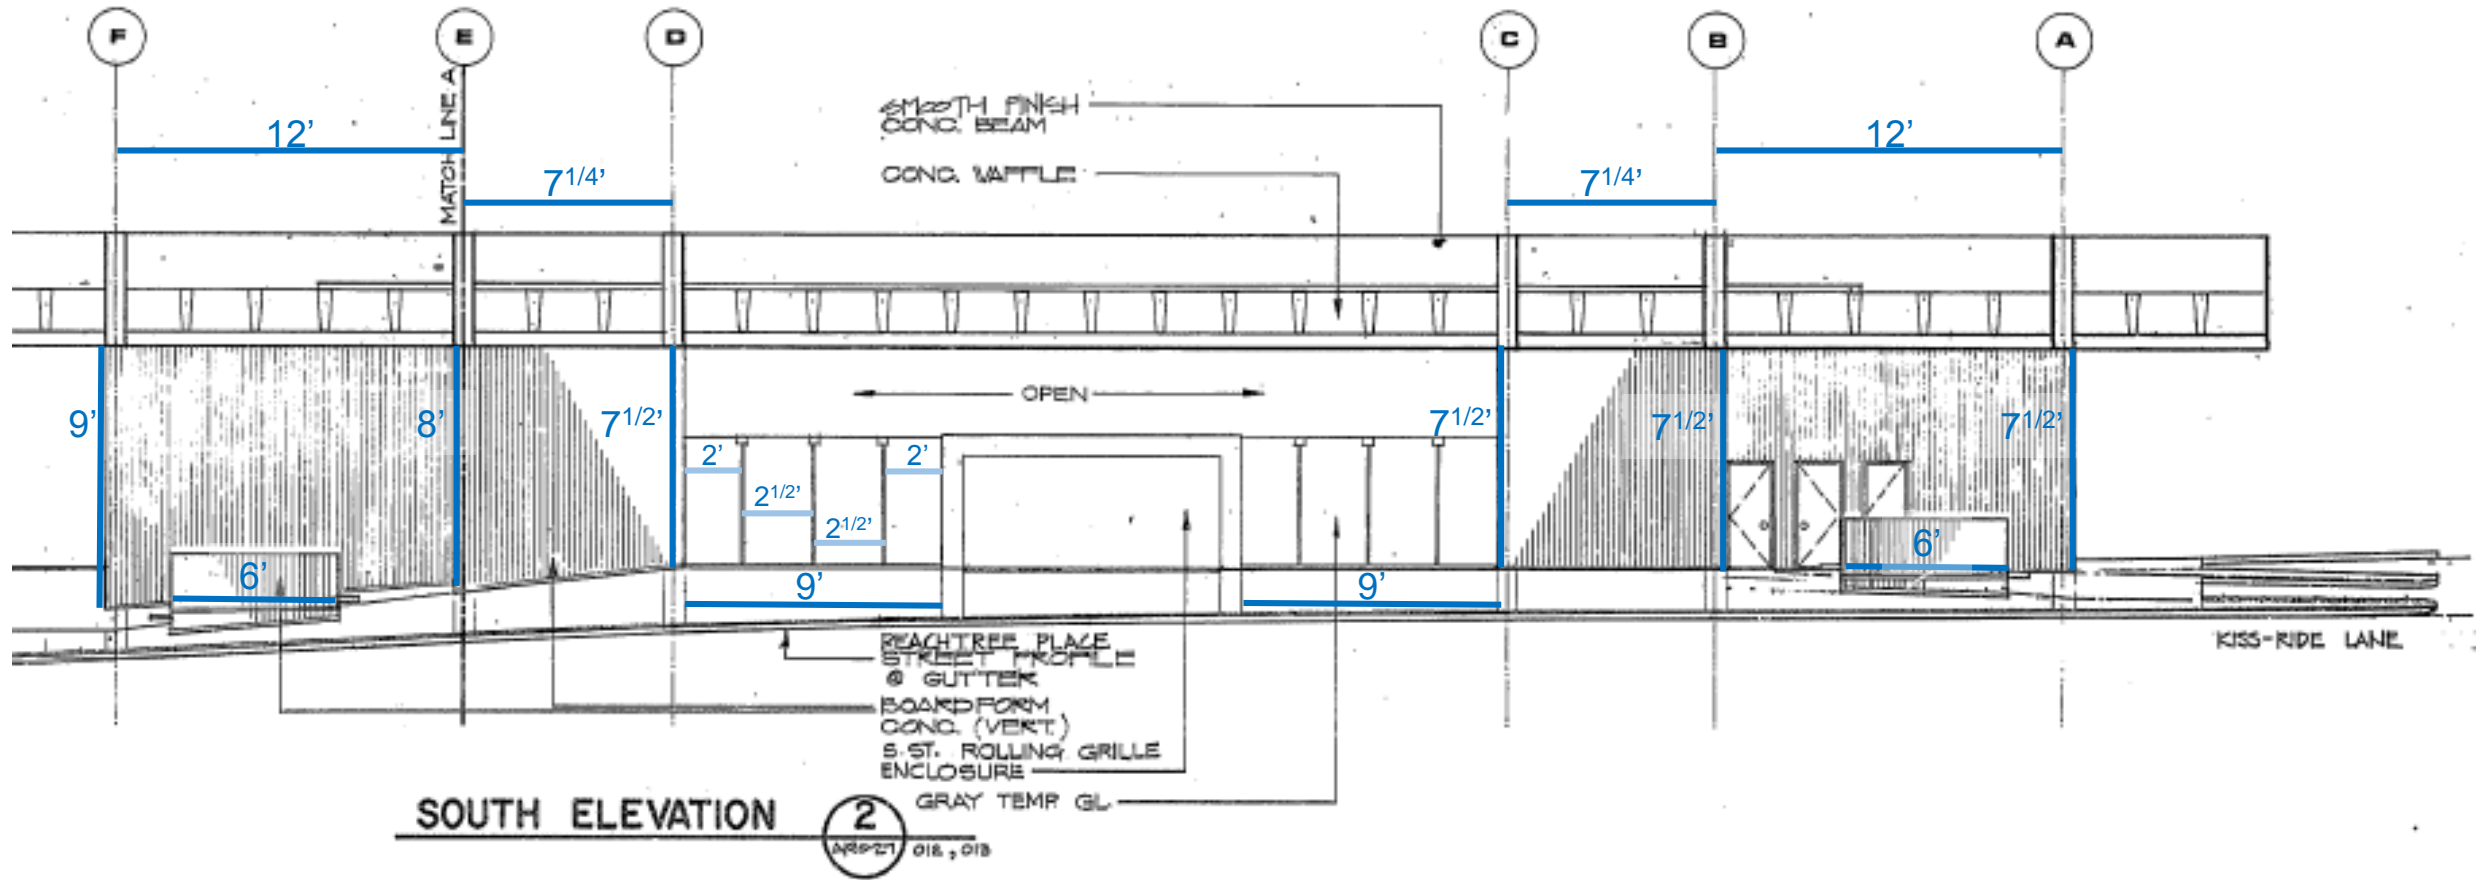

AS BUILT

PLEASE NOTE: These dimensions are meant to provide a general sense of scale, not exact measurements.